

SCALE: NONE

- 1. LOCATE ALL EQUIPMENT, WHICH MUST BE SERVICED, OPERATED, OR MAINTAINED IN FULLY ACCESSIBLE POSITIONS IN ACCORDANCE WITH MANUFACTURER'S RECOMMENDATIONS.
- 2. MAINTAIN A CLEAR PATH WITHOUT OBSTRUCTION TO ALLOW FOR ACCESS TO EQUIPMENT.
- 3. PROVIDE A MINIMUM OF THREE FEET OF CLEARANCE IN FRONT OF EQUIPMENT ACCESS DOORS AND COMPONENTS REQUIRING SERVICE, UNO.
- 4. HOUSEKEEPING PAD TO EXTEND BEYOND THE FOOTPRINT OF THE UNIT 4" IN ALL DIRECTIONS.

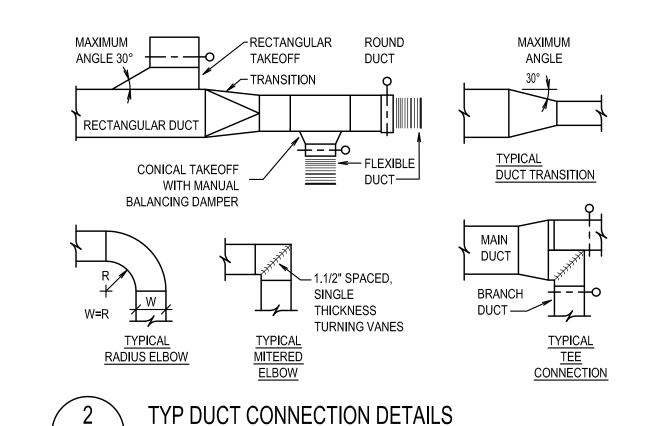

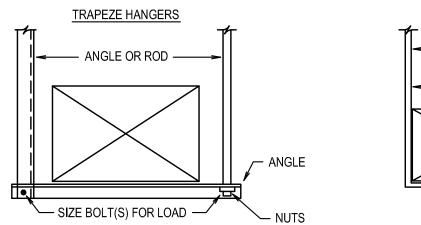



SCALE: NONE


SUPPORTED DUCTWORK.

RECTANGULAR DUCT HANGER DETAILS

SUPPORT MATERIALS AND FASTENERS SHALL BE OF SAME MATERIAL AS

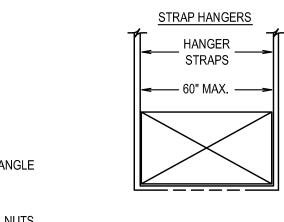

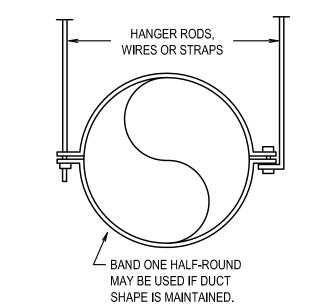

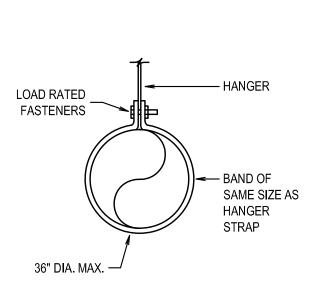

CONSULTANTS INC. 100 10th Street NE, Ste. 202

Charlottesville, VA 22902

T) 434.296.2116

design group


Facilities Planning & Construction 575 Alderman Rd / PO Box 400726 Charlottesville, VA 22904 /434-982-4621


University Virginia

ROUND DUCT HANGER DETAILS

SCALE: NONE

SUPPORT MATERIALS AND FASTENERS SHALL BE OF SAME MATERIAL AS

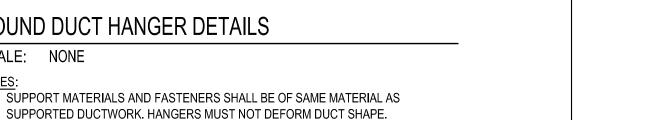

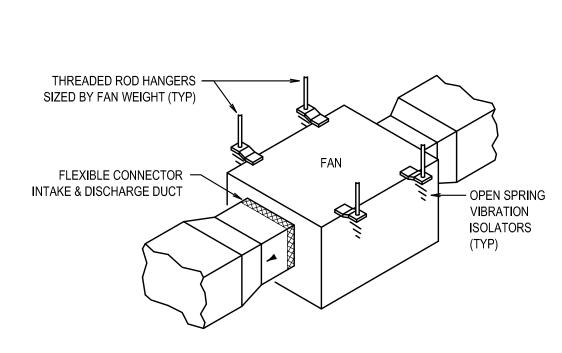


EXHAUST FAN DETAIL

EQUIPMENT, UNO.

SCALE: NONE

PROVIDE FLEXIBLE DUCT CONNECTIONS FOR ALL AIR MOVING EQUIPMENT, UNO. PROVIDE OPEN SPRING VIBRATION ISOLATORS FOR ALL SUSPENDED

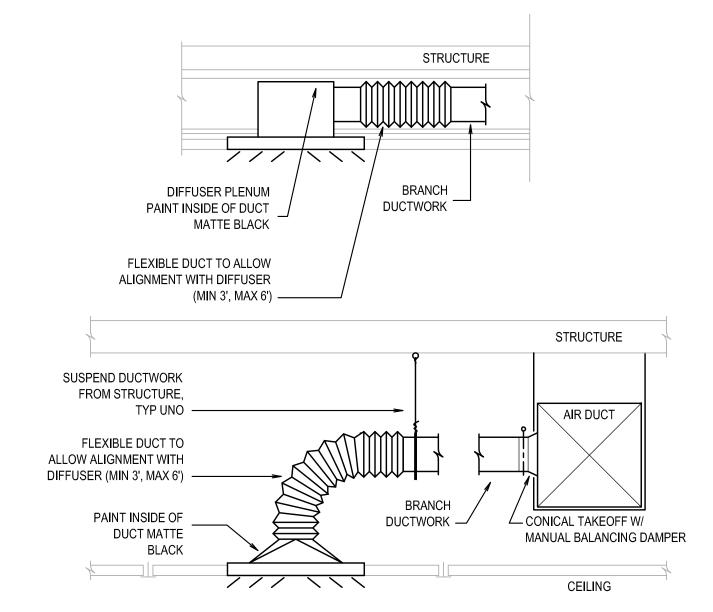


CEILING AIR DEVICE DETAILS

SCALE: NONE

1. REFER TO ARCHITECTURAL DRAWINGS, MECHANICAL FLOORPLANS, AND FIELD

VERIFY DIMENSIONS PRIOR TO INSTALLATION OF DUCTWORK. 2. INSTALL RECTANGULAR DUCTWORK TAKE-OFFS FOR ROUND BRANCH DUCTWORK AS REQUIRED TO COORDINATE WITH OTHER TRADES AND ACCOMMODATE CEILING HEIGHTS INDICATED ON ARCHITECTURAL RCPS.

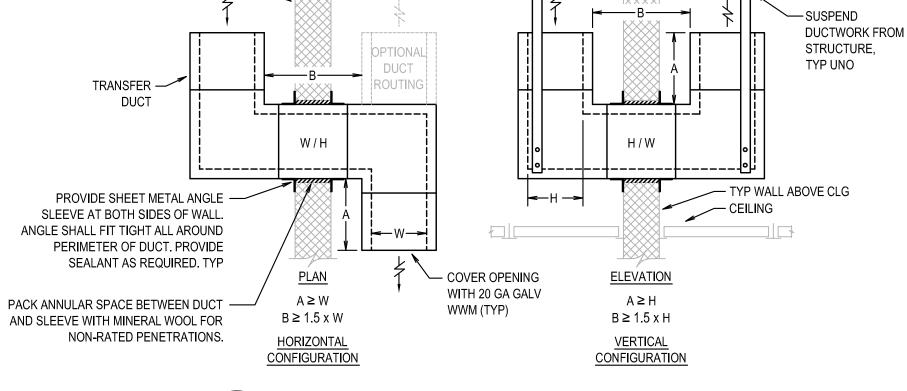

TRANSFER DUCT DETAIL

SCALE: NONE

SCALE: NONE

INSTALL DUCT ABOVE CEILING. COORDINATE INSTALLATION WITH OTHER TRADES. REFER TO FLOOR PLANS FOR TRANSFER DUCT LOCATIONS AND CONFIGURATIONS.


STRUCTURE

INSTALL DUCT IN ACCORDANCE WITH SMACNA, WITH NO TURNING VANES IN ELBOWS. LINE DUCT WITH 1" THICK ELASTOMERIC DUCT LINER WITH ANTI-MICROBIAL MYLAR COATING.

5. DIMENSIONS SHOWN ON DRAWINGS ARE INSIDE CLEAR DIMENSIONS FROM LINER SURFACE TO LINER SURFACE.

W = DUCT WIDTH: H = DUCT HEIGHT.

DETAIL IS TYPICAL FOR NON FIRE-RATED ASSEMBLIES. PROVIDE COMPONENTS AS REQUIRED TO MAINTAIN RATING OF ASSEMBLY. REFER TO FLOOR PLANS AS REQUIRED.

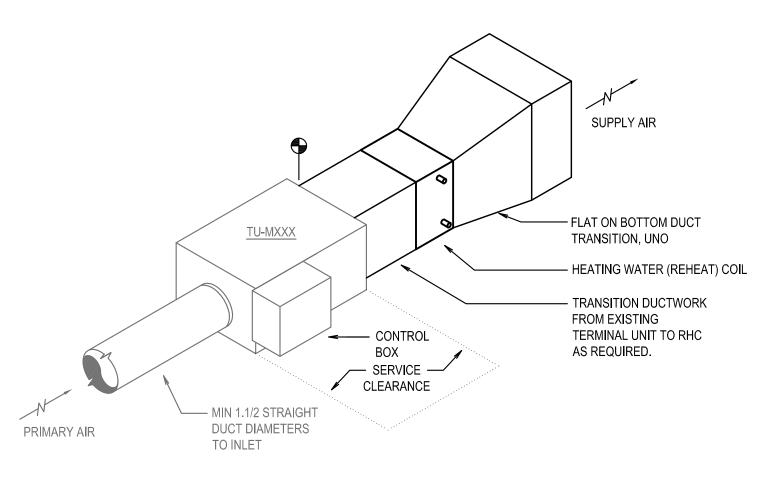


REHEAT COIL DETAIL

SCALE: NONE

REFER TO COIL PIPING DETAILS FOR HOT WATER COIL PIPING CONNECTIONS.

SUPPORT UNIT FROM STRUCTURE.

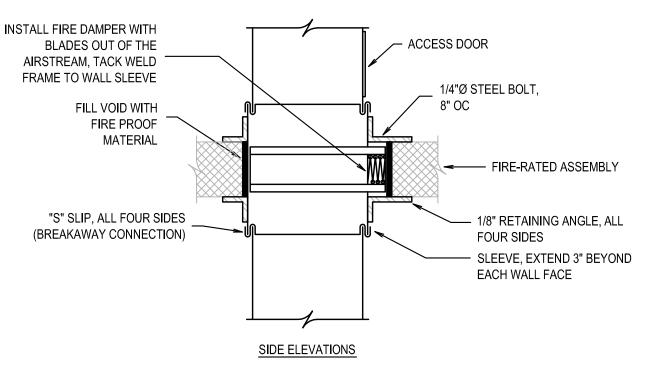


RECTANGULAR FIRE DAMPER DETAIL

SCALE: NONE

WALL SLEEVES NOT EXCEEDING 36"W X 24"H SHALL BE 16 GA. ALL LARGER SIZES

SHALL BE 14 GA. 2. DETAILS SHOWN ARE BASED ON RUSKIN AND ARE INTENDED ONLY TO SHOW BASIC SIZE AND CONFIGURATION. REFER TO SPECIFICATIONS FOR TECH. REQUIREMENTS.

3. THIS TYPICAL FIRE DAMPER IS FOR GENERIC GUIDANCE ONLY. INSTALL FIRE DAMPER IN ACCORDANCE WITH THE MANUFACTURER'S INSTALLATION DETAILS. DO NOT VARY FROM THOSE INSTRUCTIONS IN ANY WAY. DO NOT FIRESTOP THE GAP BETWEEN THE FIRE DAMPER AND SLEEVE AND THE PENETRATION UNLESS SPECIFICALLY REQUIRED BY THE MANUFACTURER'S INSTALLATION INSTRUCTIONS.

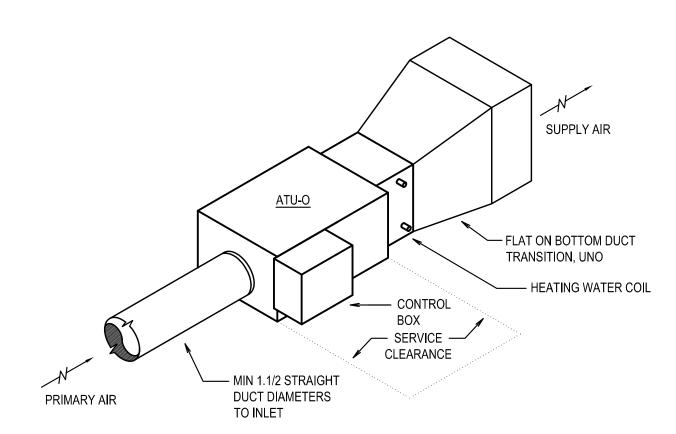




SHUT OFF ATU DETAIL

SCALE: NONE

REFER TO COIL PIPING DETAILS FOR HOT WATER COIL PIPING CONNECTIONS.

2. PROVIDE MIN 1-1/2 DUCT DIAMETERS STRAIGHT ROUND DUCT UPSTREAM OF ATU PRIMARY AIR INLET. DUCT SHALL BE SIZE OF INLET CONNECTION.

SUPPORT UNIT FROM STRUCTURE.

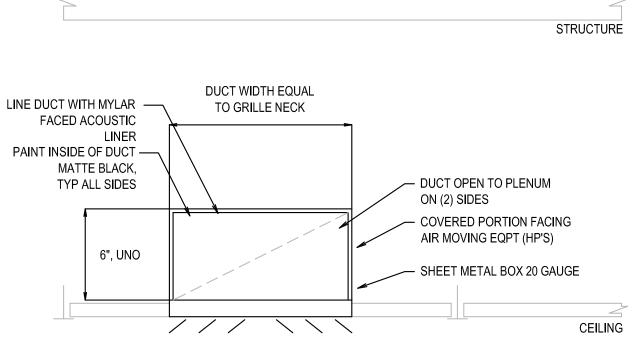




SCALE: NONE

PLENUM CEILING RETURN GRILLE DETAIL



1. PAINT VISIBLE AREAS ABOVE CEILING RETURN GRILLE MATTE BLACK.

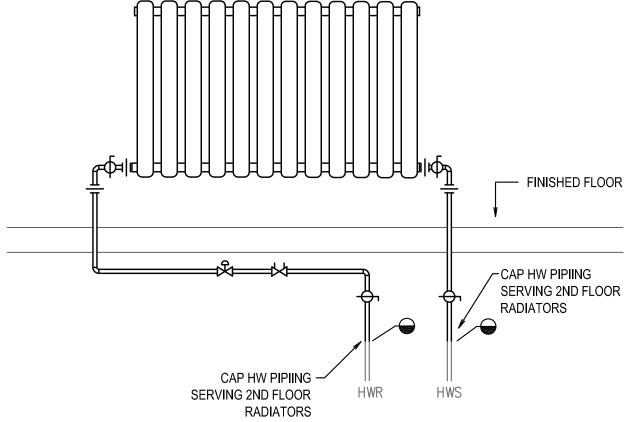



RADIATOR VALVE DETAIL

SCALE: NONE

1. TERMINATE PIPING A MINIMUM OF 6" BELOW UNDERSIDE OF SECOND FLOOR ASSEMBLY.

DETAILS

DRAWN BY: CJP/BNM CHECKED BY: PMM REVISIONS

PROJECT NUMBER

VATIONS NO. 0202 OR RENOV, BUILDING N SECOND OLSSON HA

RECORD DRAWINGS

DATE: 04/23/18

P04406

SHEET