2. INSTALL EF-SNORKEL ON WOOD PLATFORM COMPLETE WITH VIBRATION ISOLATORS.

design group

Facilities Planning & Construction 575 Alderman Rd / PO Box 400726 Charlottesville, VA 22904 /434-982-4621

CONSULTANTS INC.

100 10th Street NE, Ste. 202
Charlottesville, VA 22902

T) 434.296.2116

SECOND FLOOR RENOVATIONS OLSSON HALL; BUILDING NO. 0202

> RECORD DRAWINGS


ATTIC MECH DUCT

DATE: 04/23/18 DRAWN BY: CJP/BNM CHECKED BY: PMM REVISIONS

> PROJECT NUMBER PO4406

M1.1

SHEET

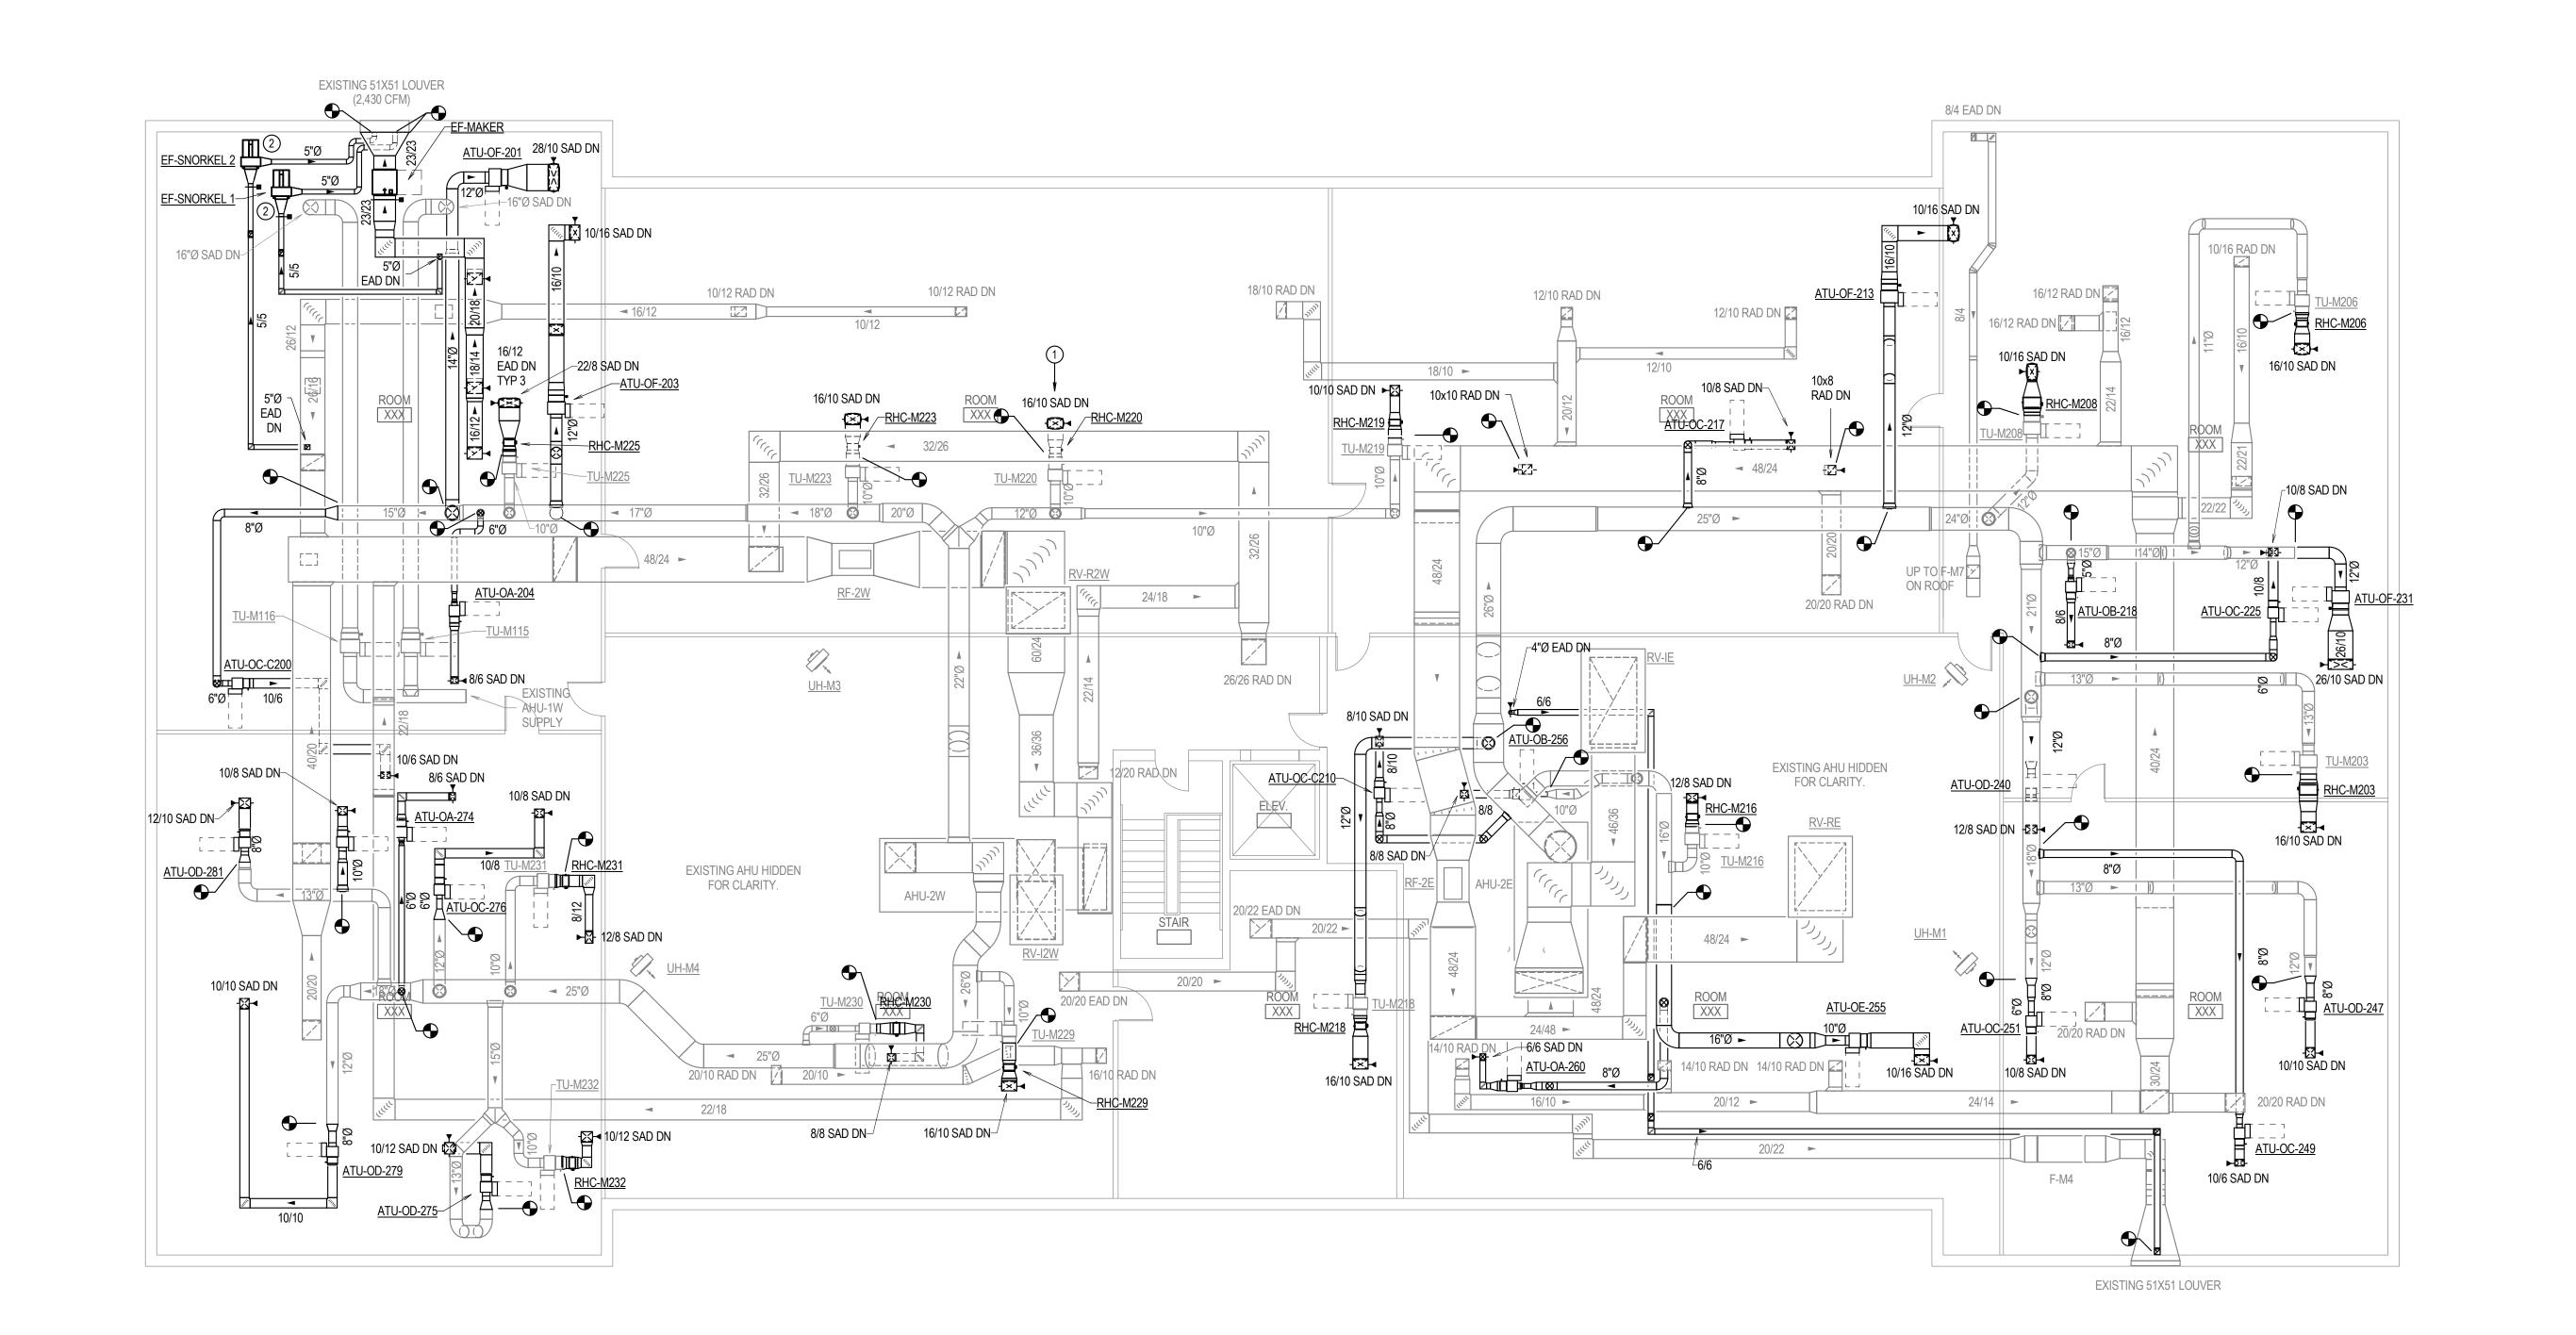

ATTIC MECHANICAL DUCTWORK

SCALE: 1/8" = 1'-0"