3. PROVIDE BRANCH PIPING TO ALL NEW RHC'S. REFER TO RHC SCHEDULE FOR BRANCH PIPE SIZING. REUSE EXISTING BAS CONTROL VALVE. PROVIDE ALL OTHER NEW COMPONENTS AS INDICATED ON HW COIL DETAIL. Facilities Planning & Construction 575 Alderman Rd / PO Box 400726 Charlottesville, VA 22904 /434-982-4621

100 10th Street NE, Ste. 202 Charlottesville, VA 22902 T) 434.296.2116

0202 FLOOR RENOVATIONS BUILDING NO ALL;

SECOND

RECORD DRAWINGS


OLSSON H

ATTIC MECH PIPING

DATE: 04/23/18 DRAWN BY: CJP/BNM CHECKED BY: PMM REVISIONS

PROJECT NUMBER PO4406

M2.1SHEET

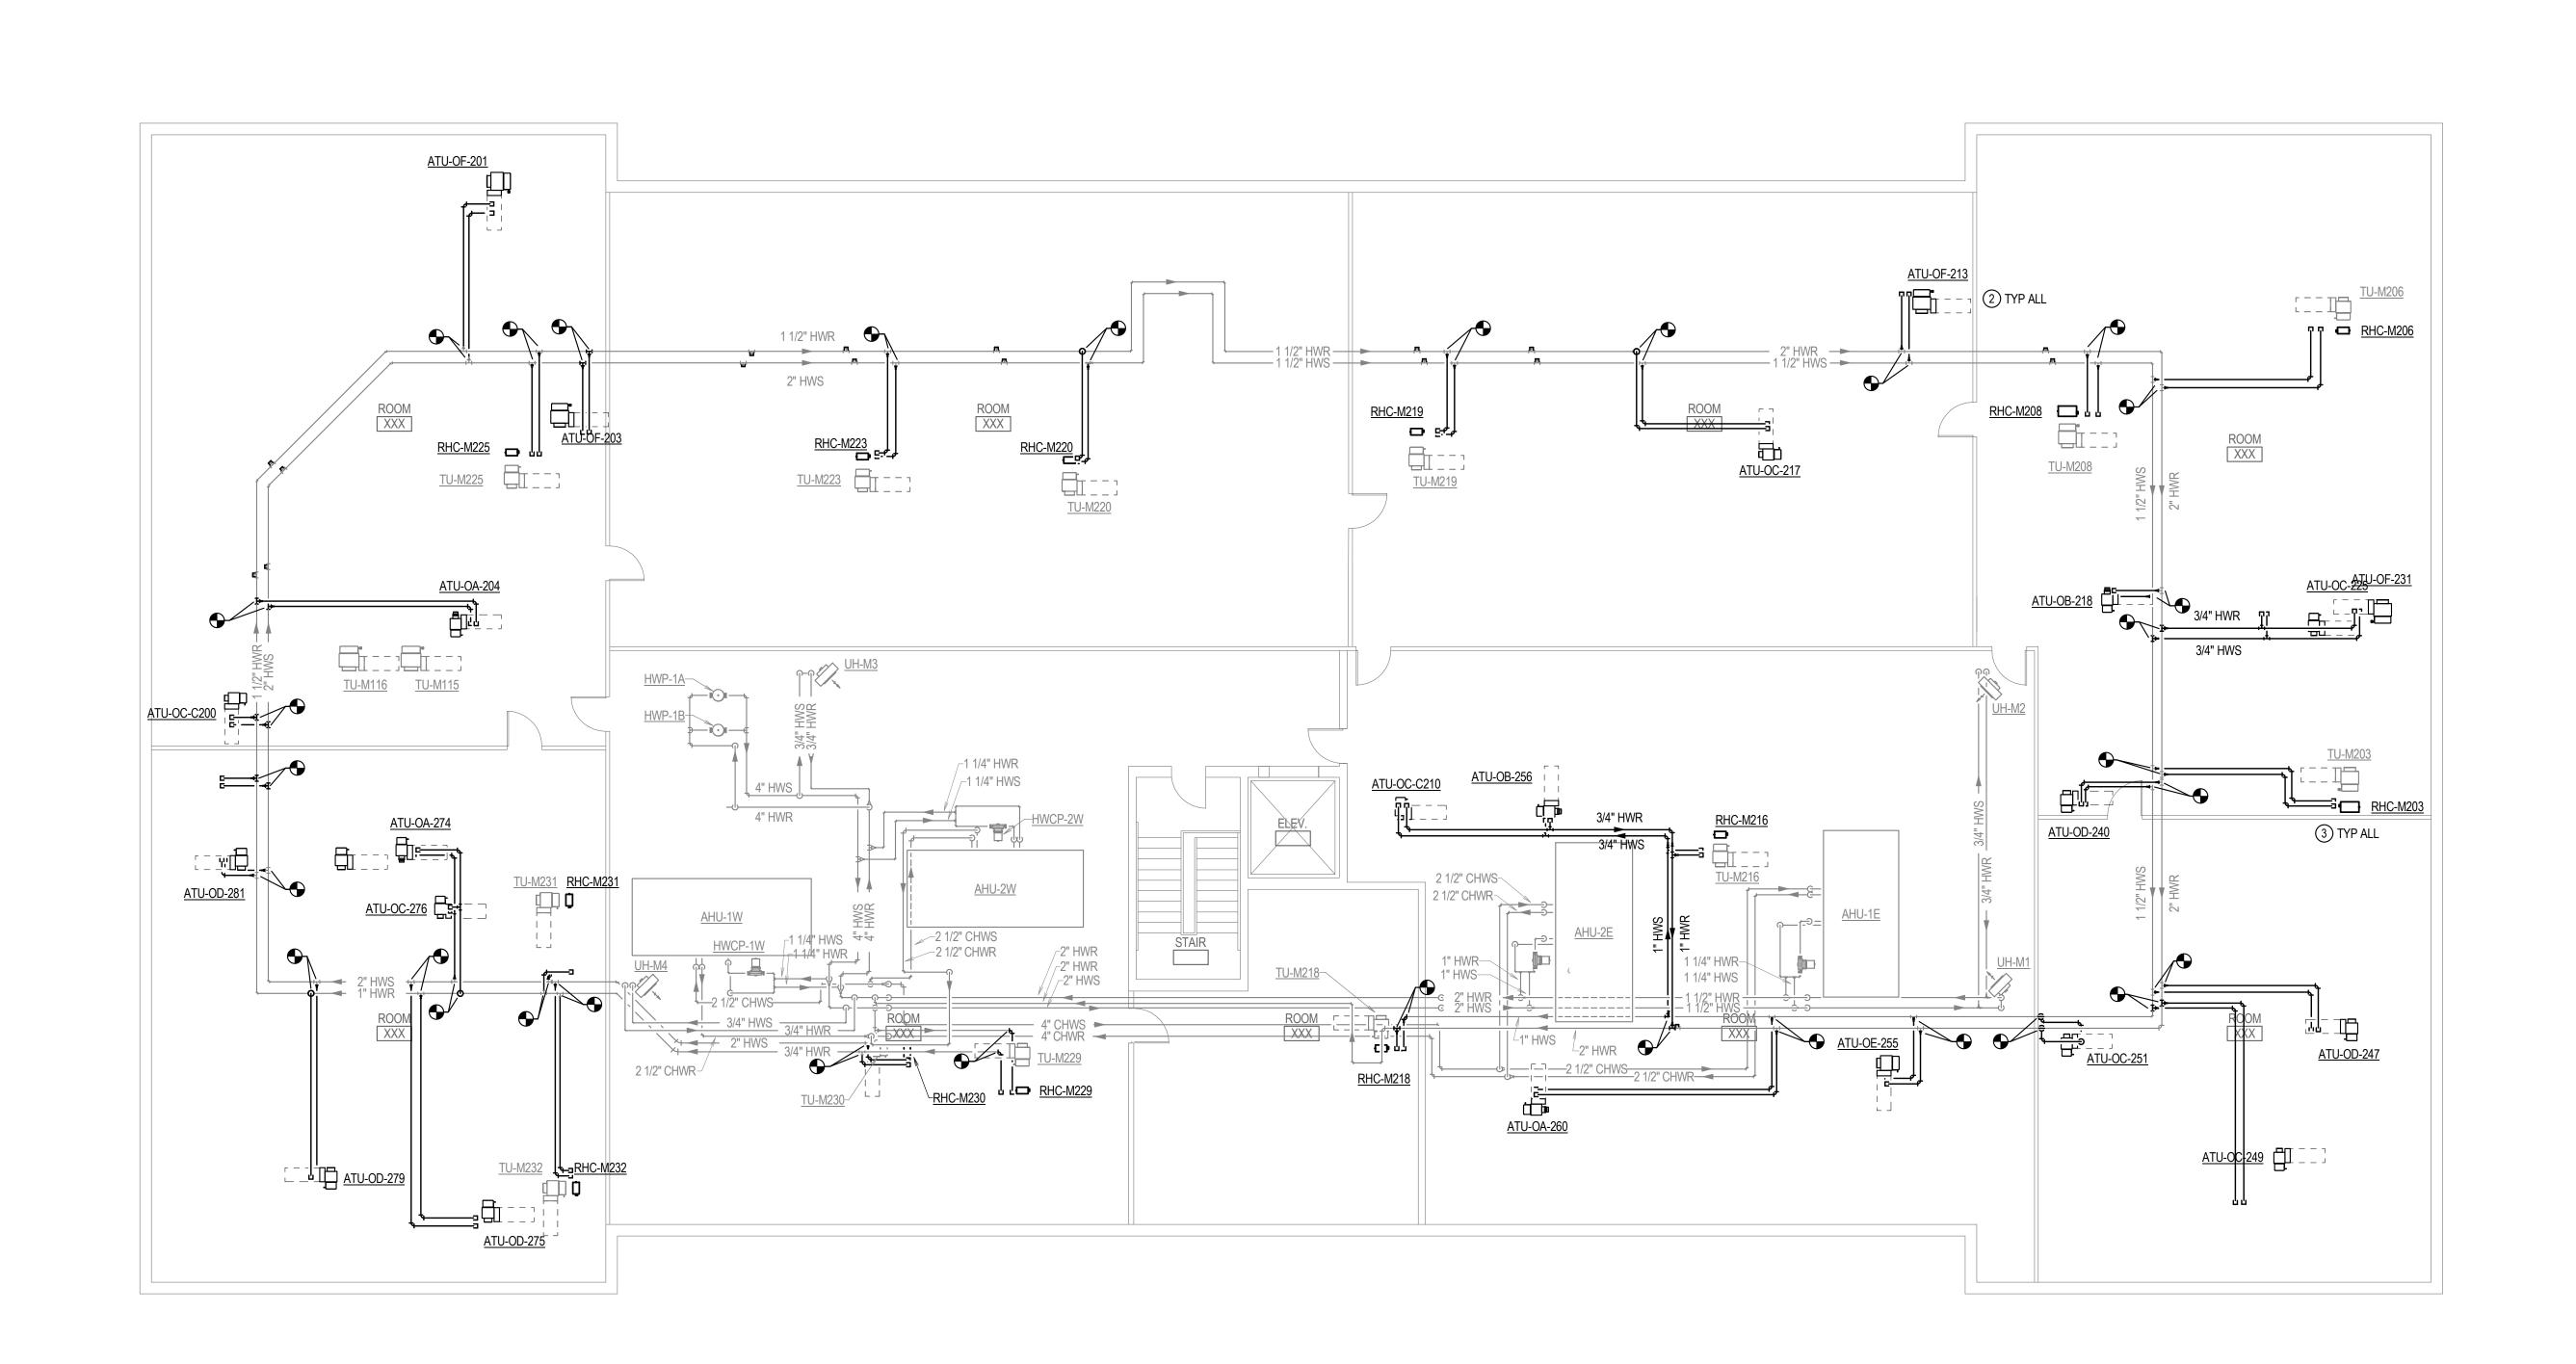

ATTIC MECHANICAL PIPING

SCALE: 1/8" = 1'-0"